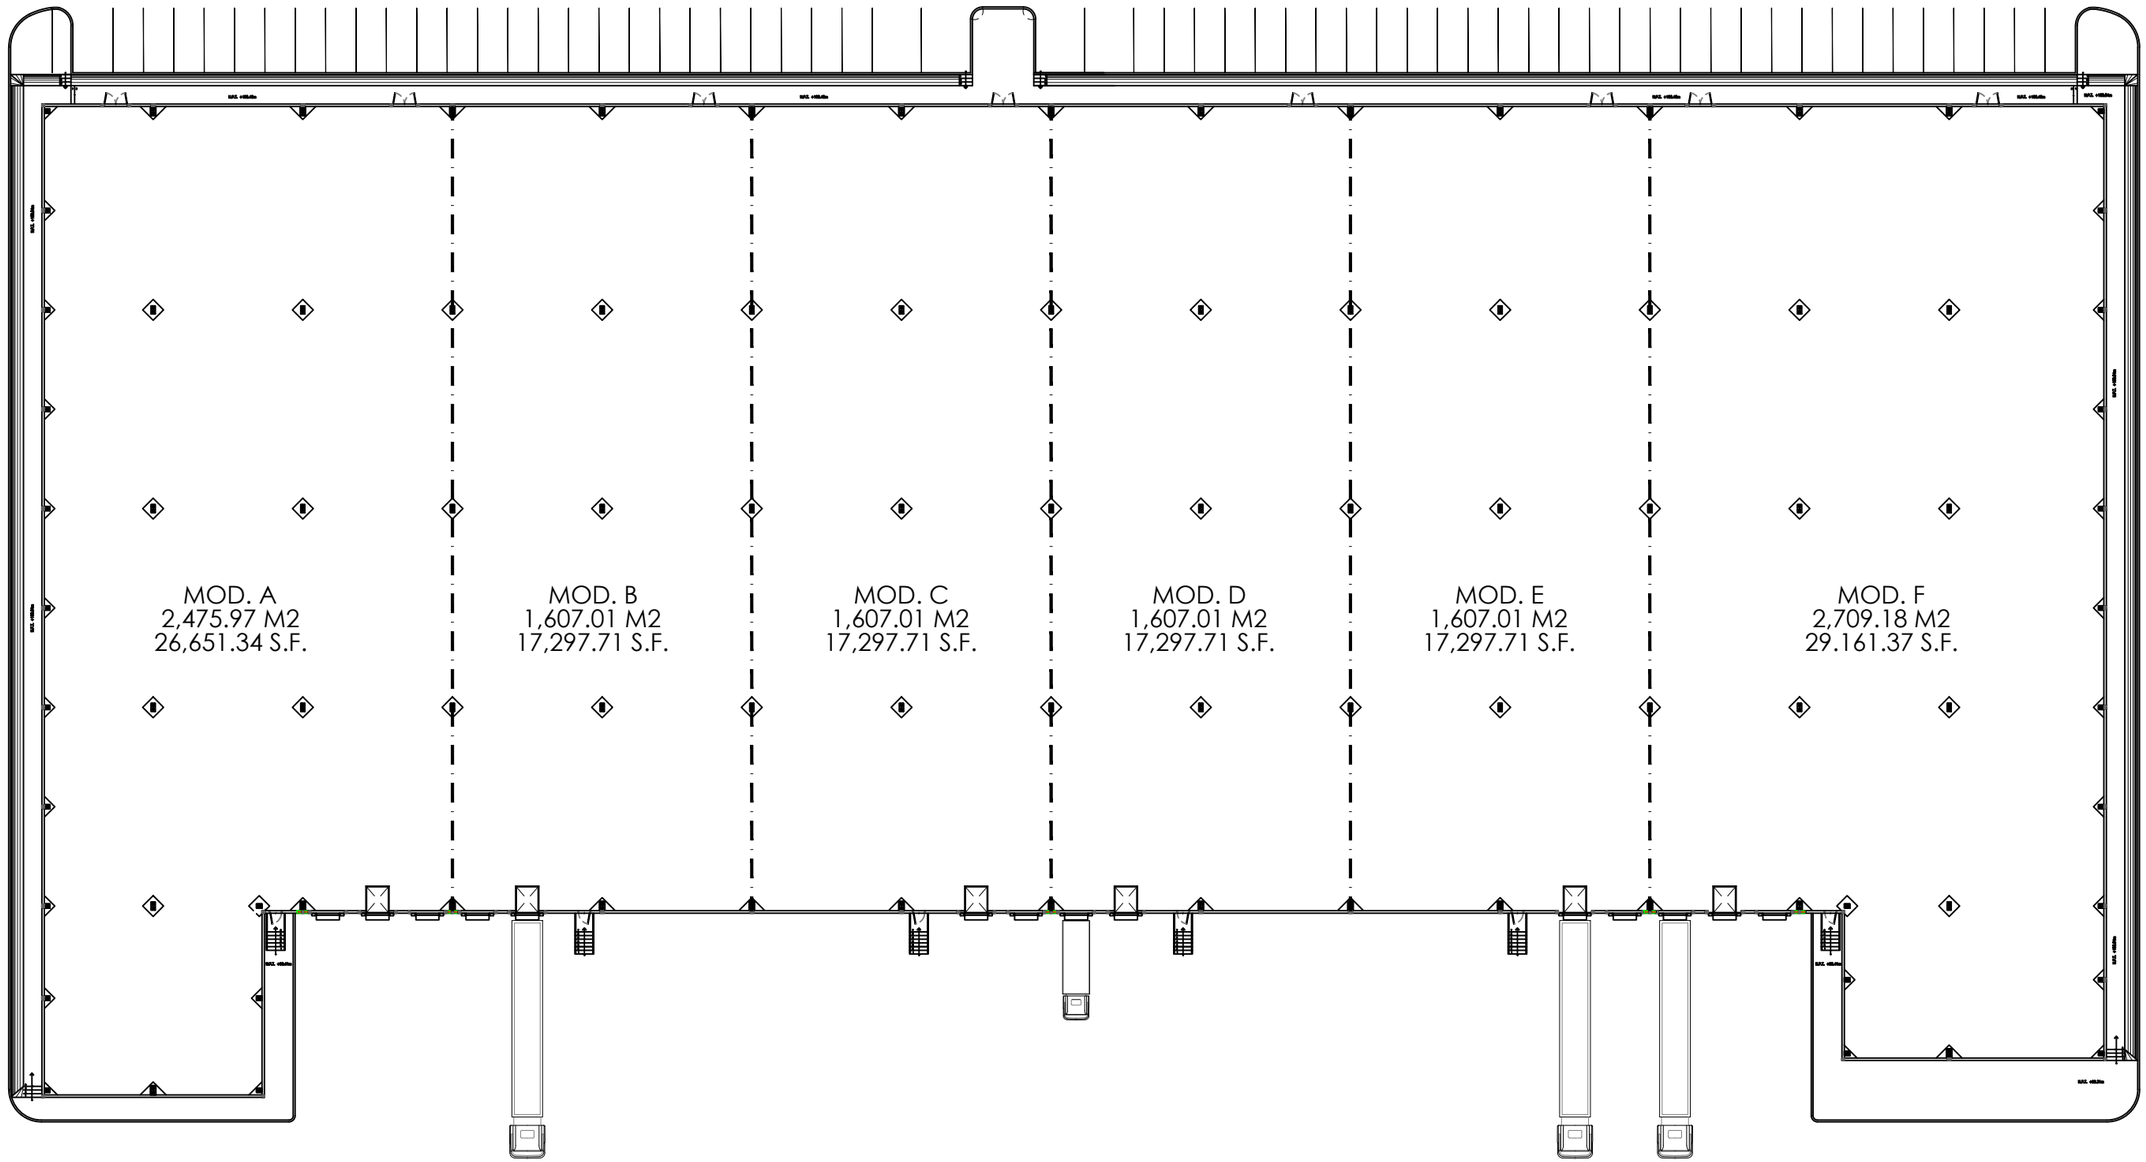


onni group

ENSENADA INDUSTRIAL PARK

BUILDING 1

22970 ENSENADA, B.C. MEXICO

DRAWN BY: MD

SCALE: NOT TO SCALE

ISSUE: 11/17/2026

REVISIONS:

SHEET TITLE:

AS-BUILT

SHEET:

ID1.01