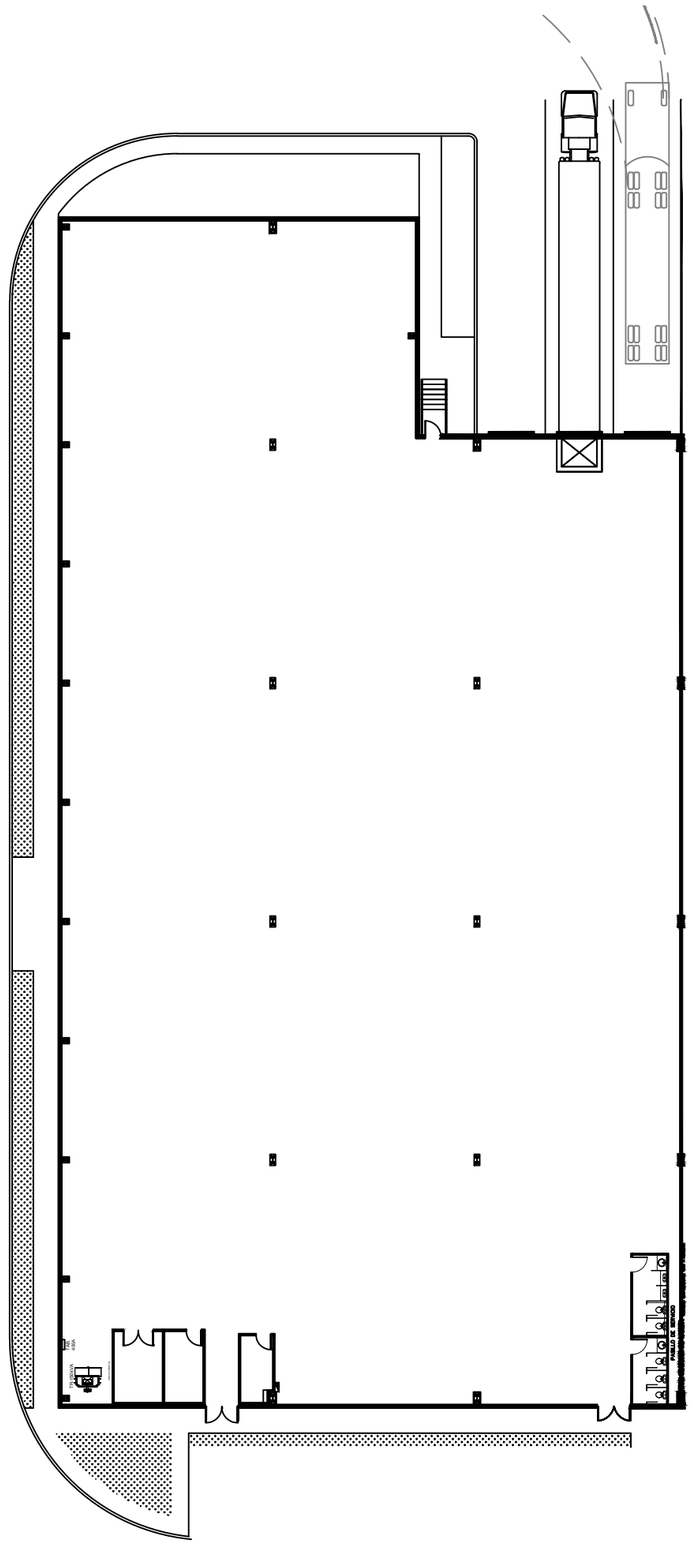


ENSENADA INDUSTRIAL PARK

BUILDING 4 - UNIT A

BUILDING ADDRESS

22790 ENSENADA, B.C., MEXICO

26,271 S.F.

DRAWN BY: MD	
SCALE: NOT TO SCALE	
ISSUE: 10/19/2026	
REVISIONS:	

SHEET TITLE:

AS-BUILT

SHEET:

ID1.02