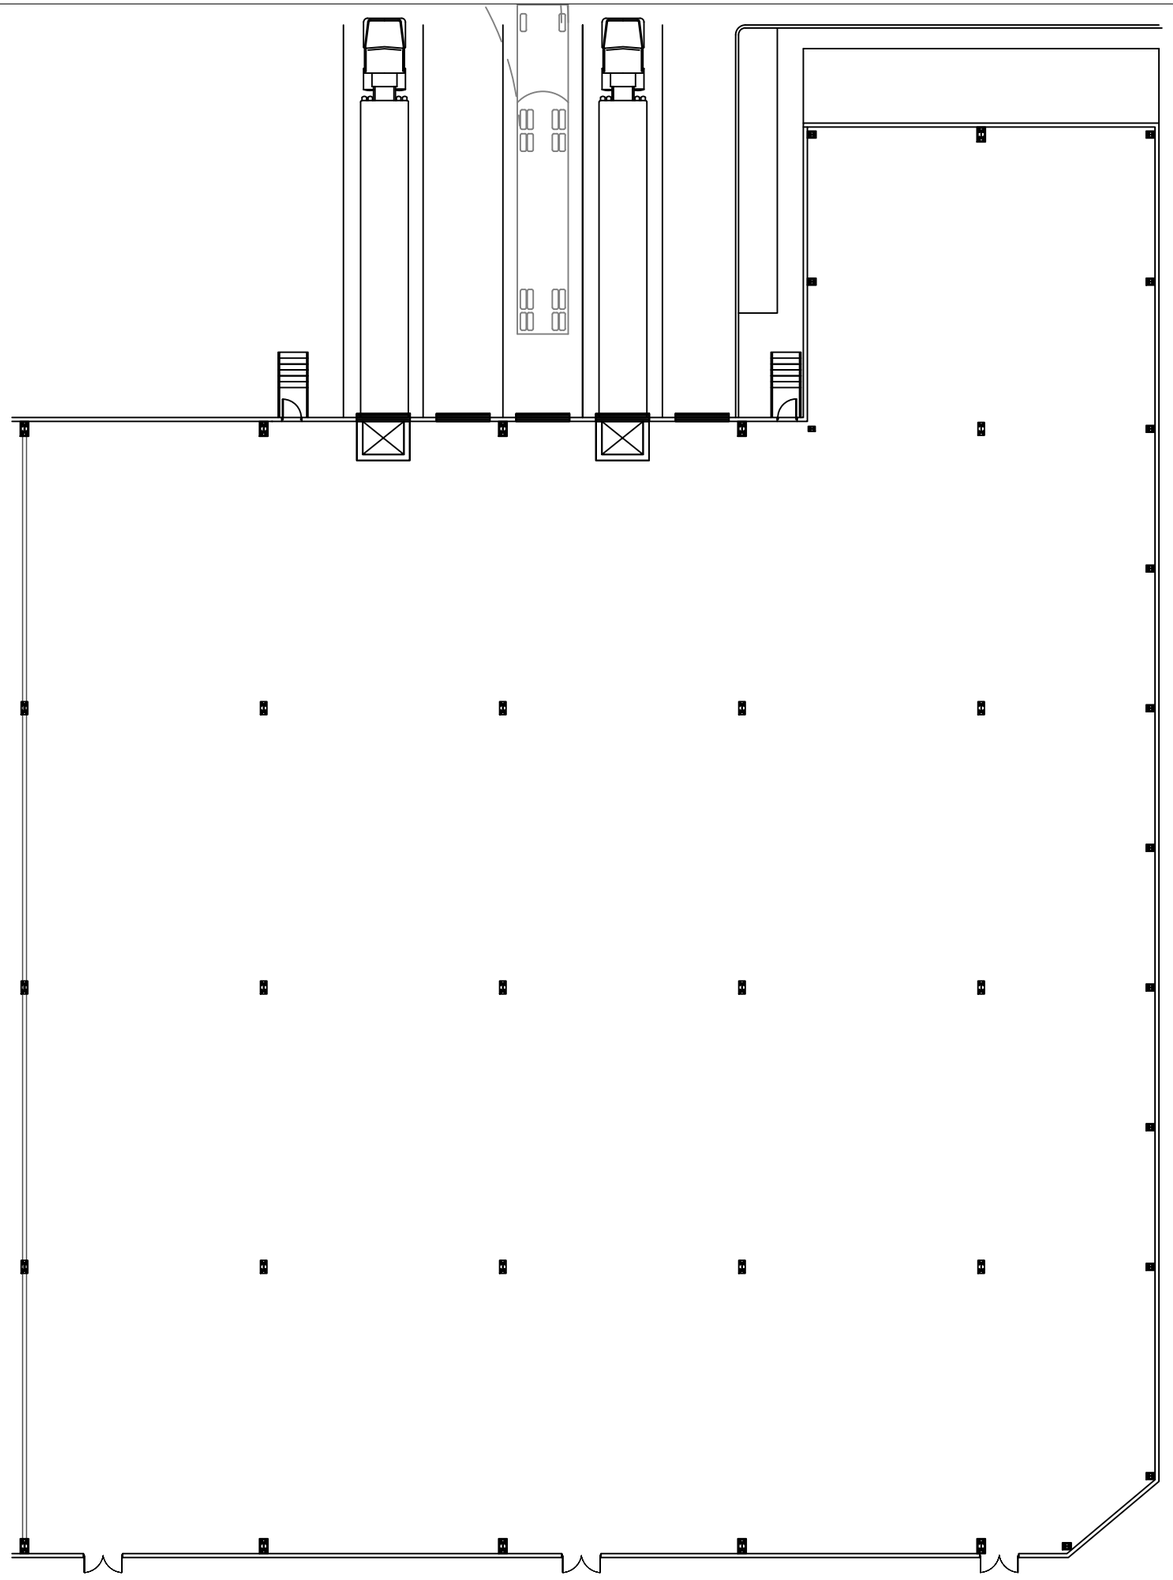


onni group

ENSENADA INDUSTRIAL PARK

BUILDING 4 - UNIT E/F

22790 ENSENADA, B.C., MEXICO

38,999 S.F.

DRAWN BY: MD

SCALE: NOT TO SCALE

ISSUE: 10/27/2026

REVISIONS:

SHEET TITLE:

AS-BUILT

SHEET:

ID1.01