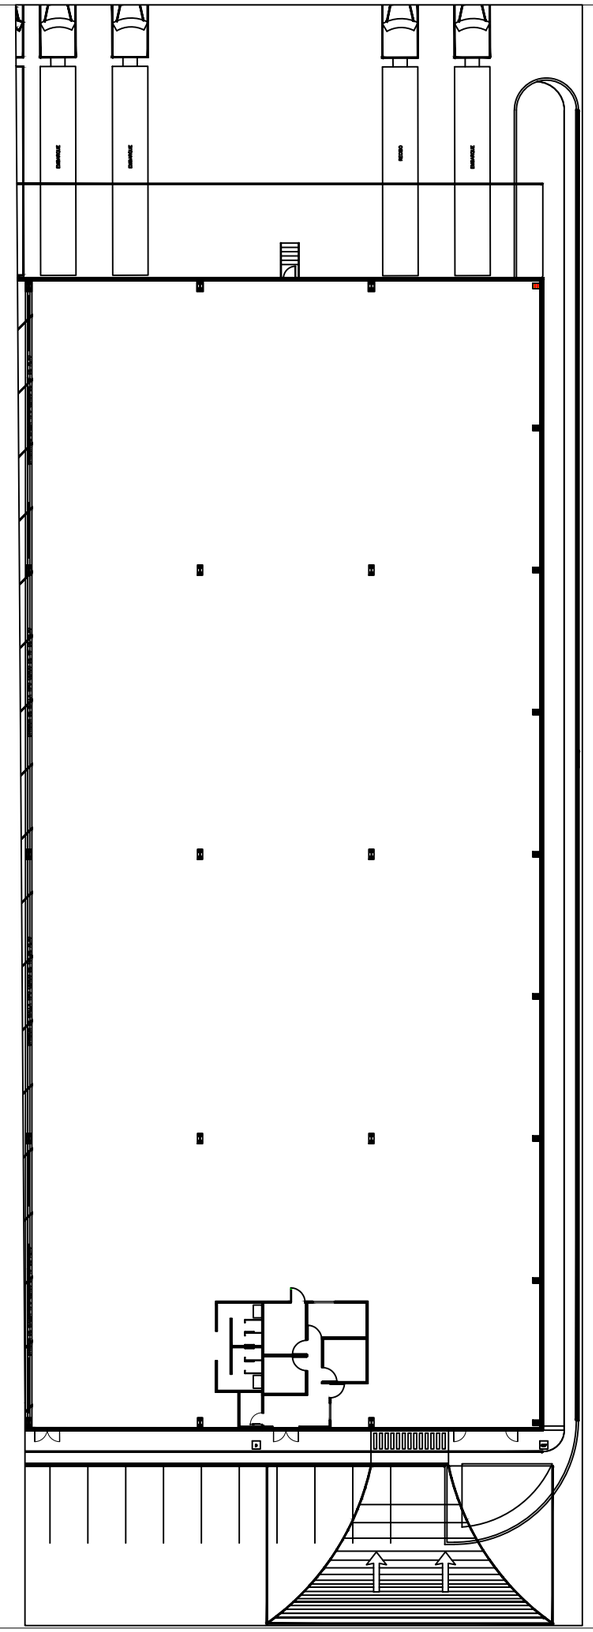


onni group

ENSENADA INDUSTRIAL PARK

BUILDING 5 - UNIT F

22790 ENSENADA, B.C. MEXICO

31,345 S.F.

DRAWN BY: MD

SCALE: 1/32" = 1'-0"

ISSUE: 11/4/2026

REVISIONS:

SHEET TITLE:

AS-BUILT

SHEET:

ID1.01